




Rev.	Date	Reason	Approved
AB1	07/26	As-built	DB

AS BUILT

CAD ref: 41556.Asbuilts combined

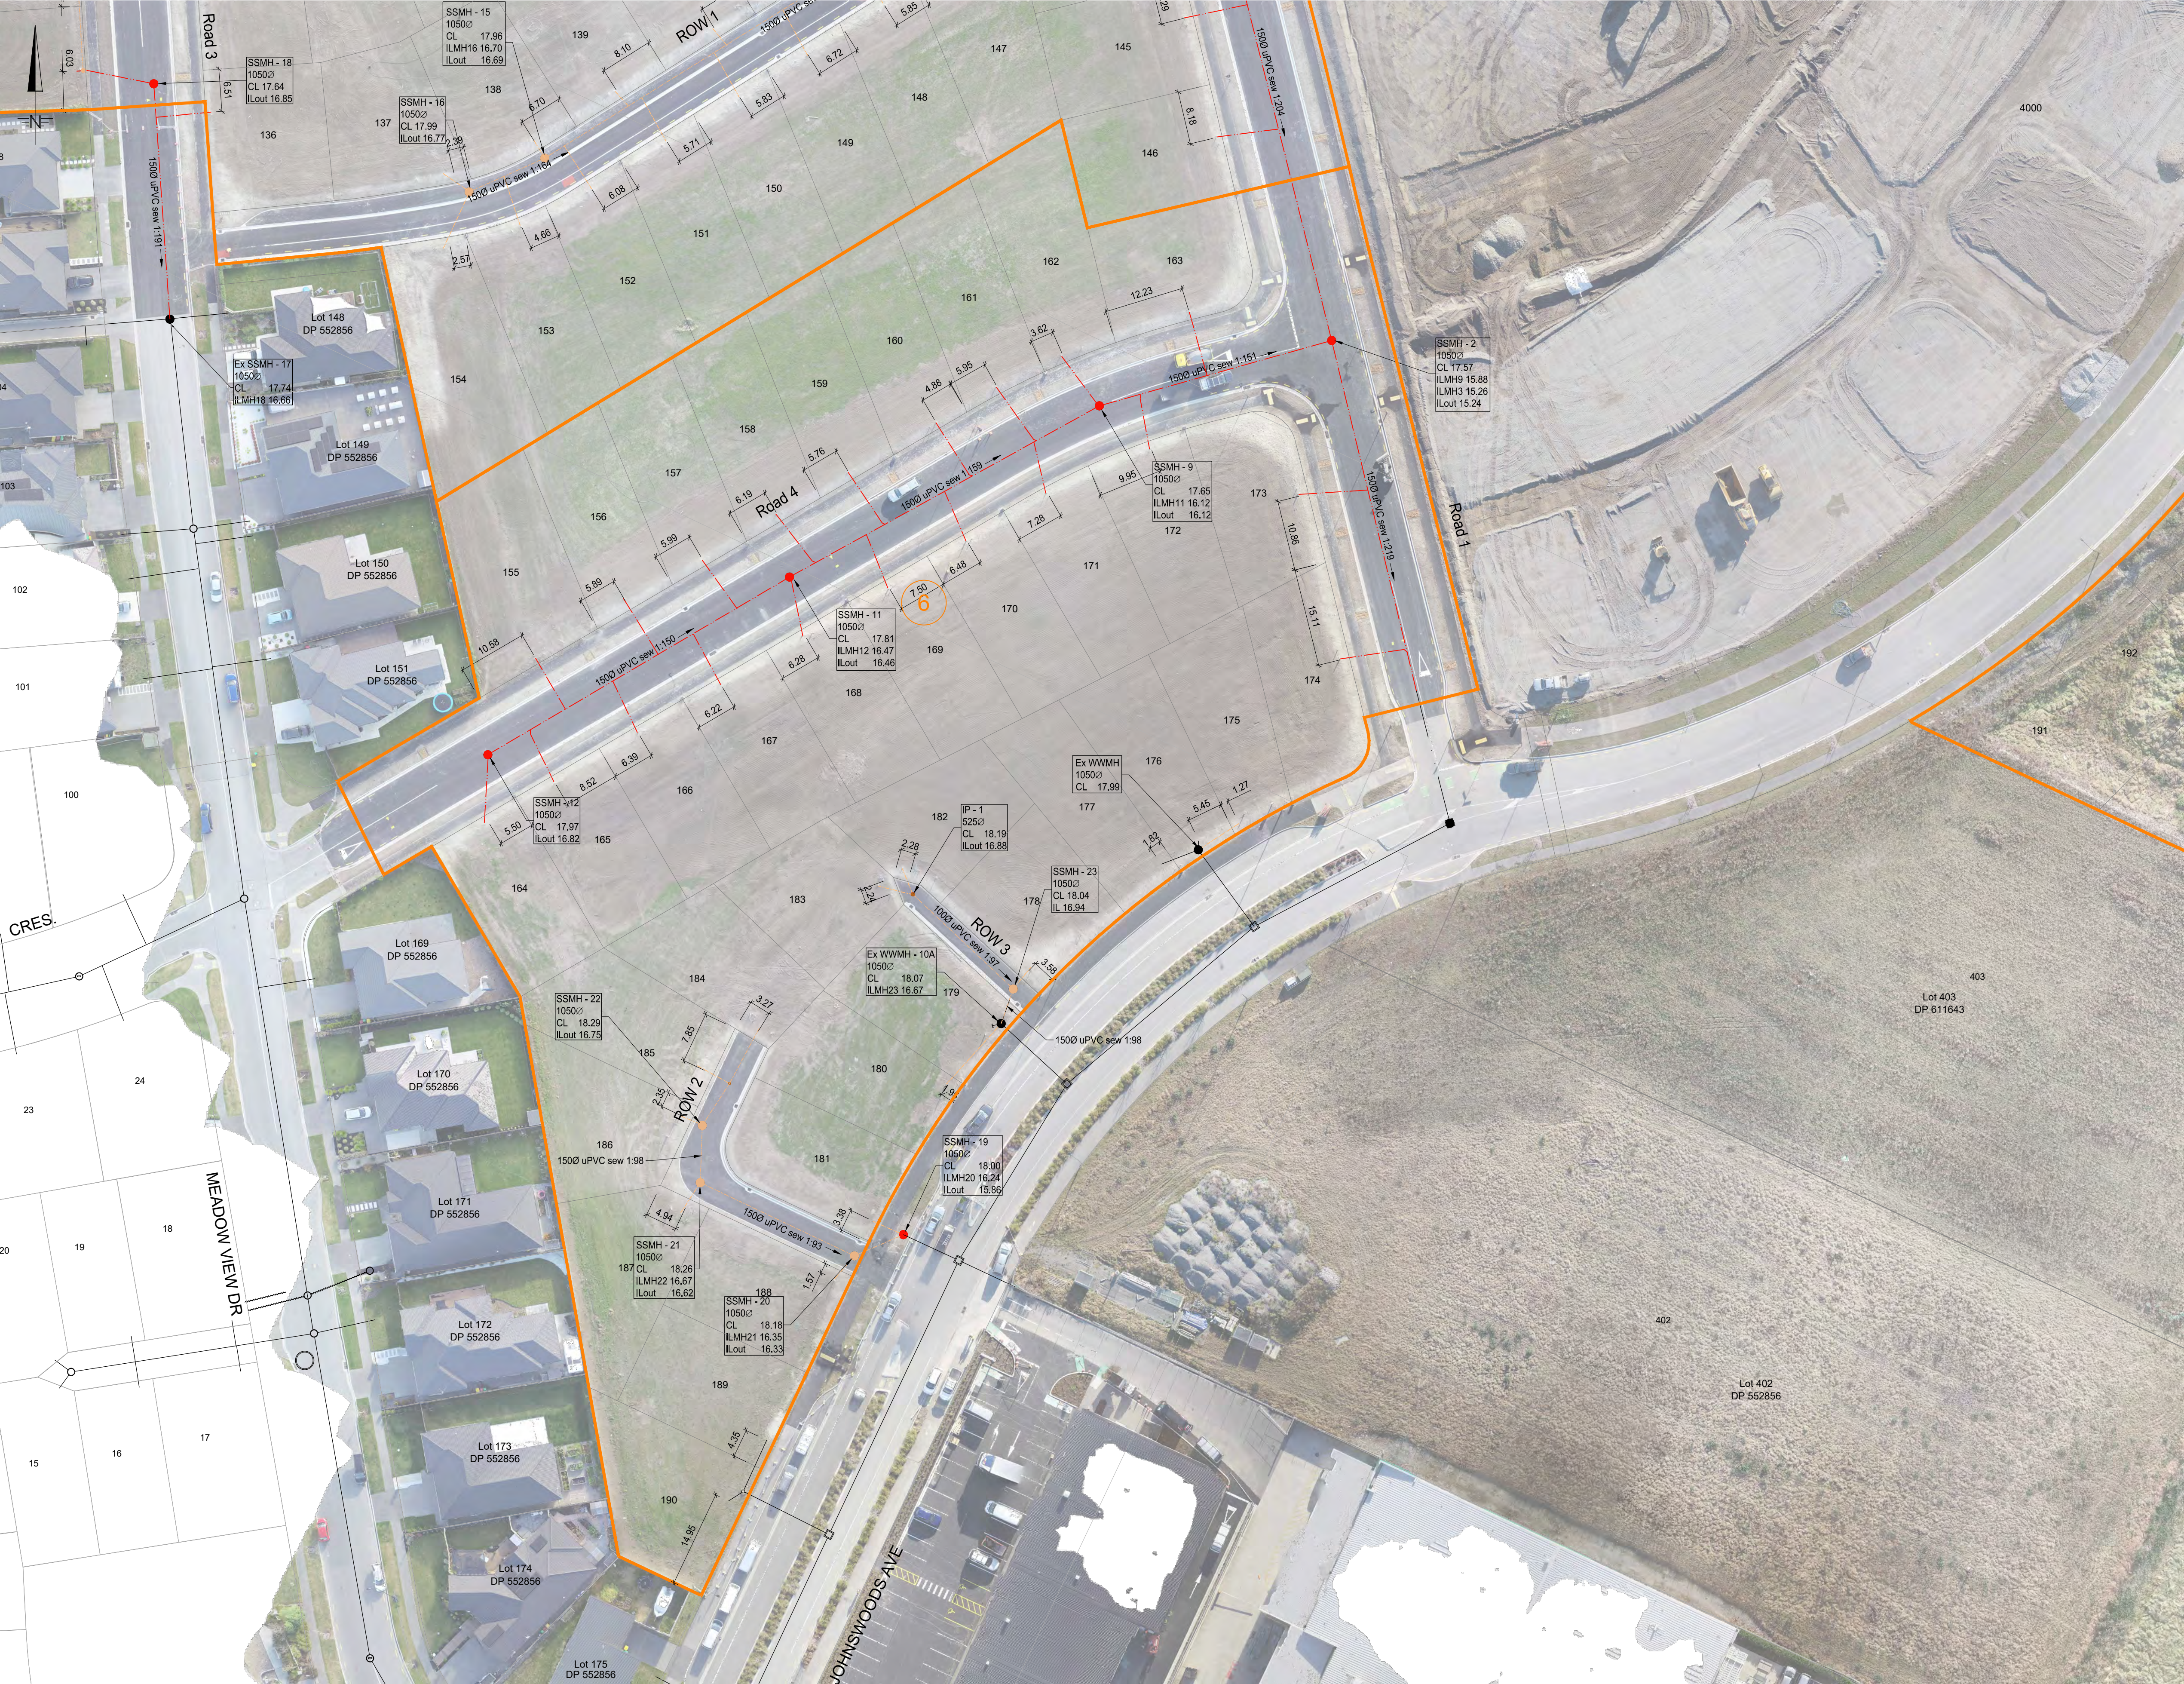

Davis Ogilvie & Partners Limited
Level 1, 24 Moorhouse Avenue, Addington, Christchurch 8140
Office 0800 999 333 Email hello@do.nz
www.do.nz

BELFAST SUBDIVSION,
JOHNSWOODS AVE, BELFAST

AS-BUILT - STAGE 6 & 8
SEWER - SHEET 1 OF 2

Design	Drawn	QA Check	Dwg No.
DB	IZ	DB	AB01
Scale @ A1	Date	Job No.	Rev.
1:500 (m)	07/26	41556	AB1



Rev.	Date	Reason	Approved
AB1	07/26	As-built	DB

AS BUILT

CAD ref: 41556.Asbuilts combined




Rev.	Date	Reason	Approved
AB1	07/26	As-built	DB

AS BUILT

CAD ref: 41556.Asbuilts combined

AS BUILT

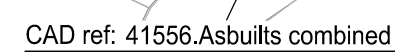




Rev.	Date	Reason	Approved
AB1	07/26	As-built	DB

AS BUILT

CAD ref: 41556.Asbuilts combined

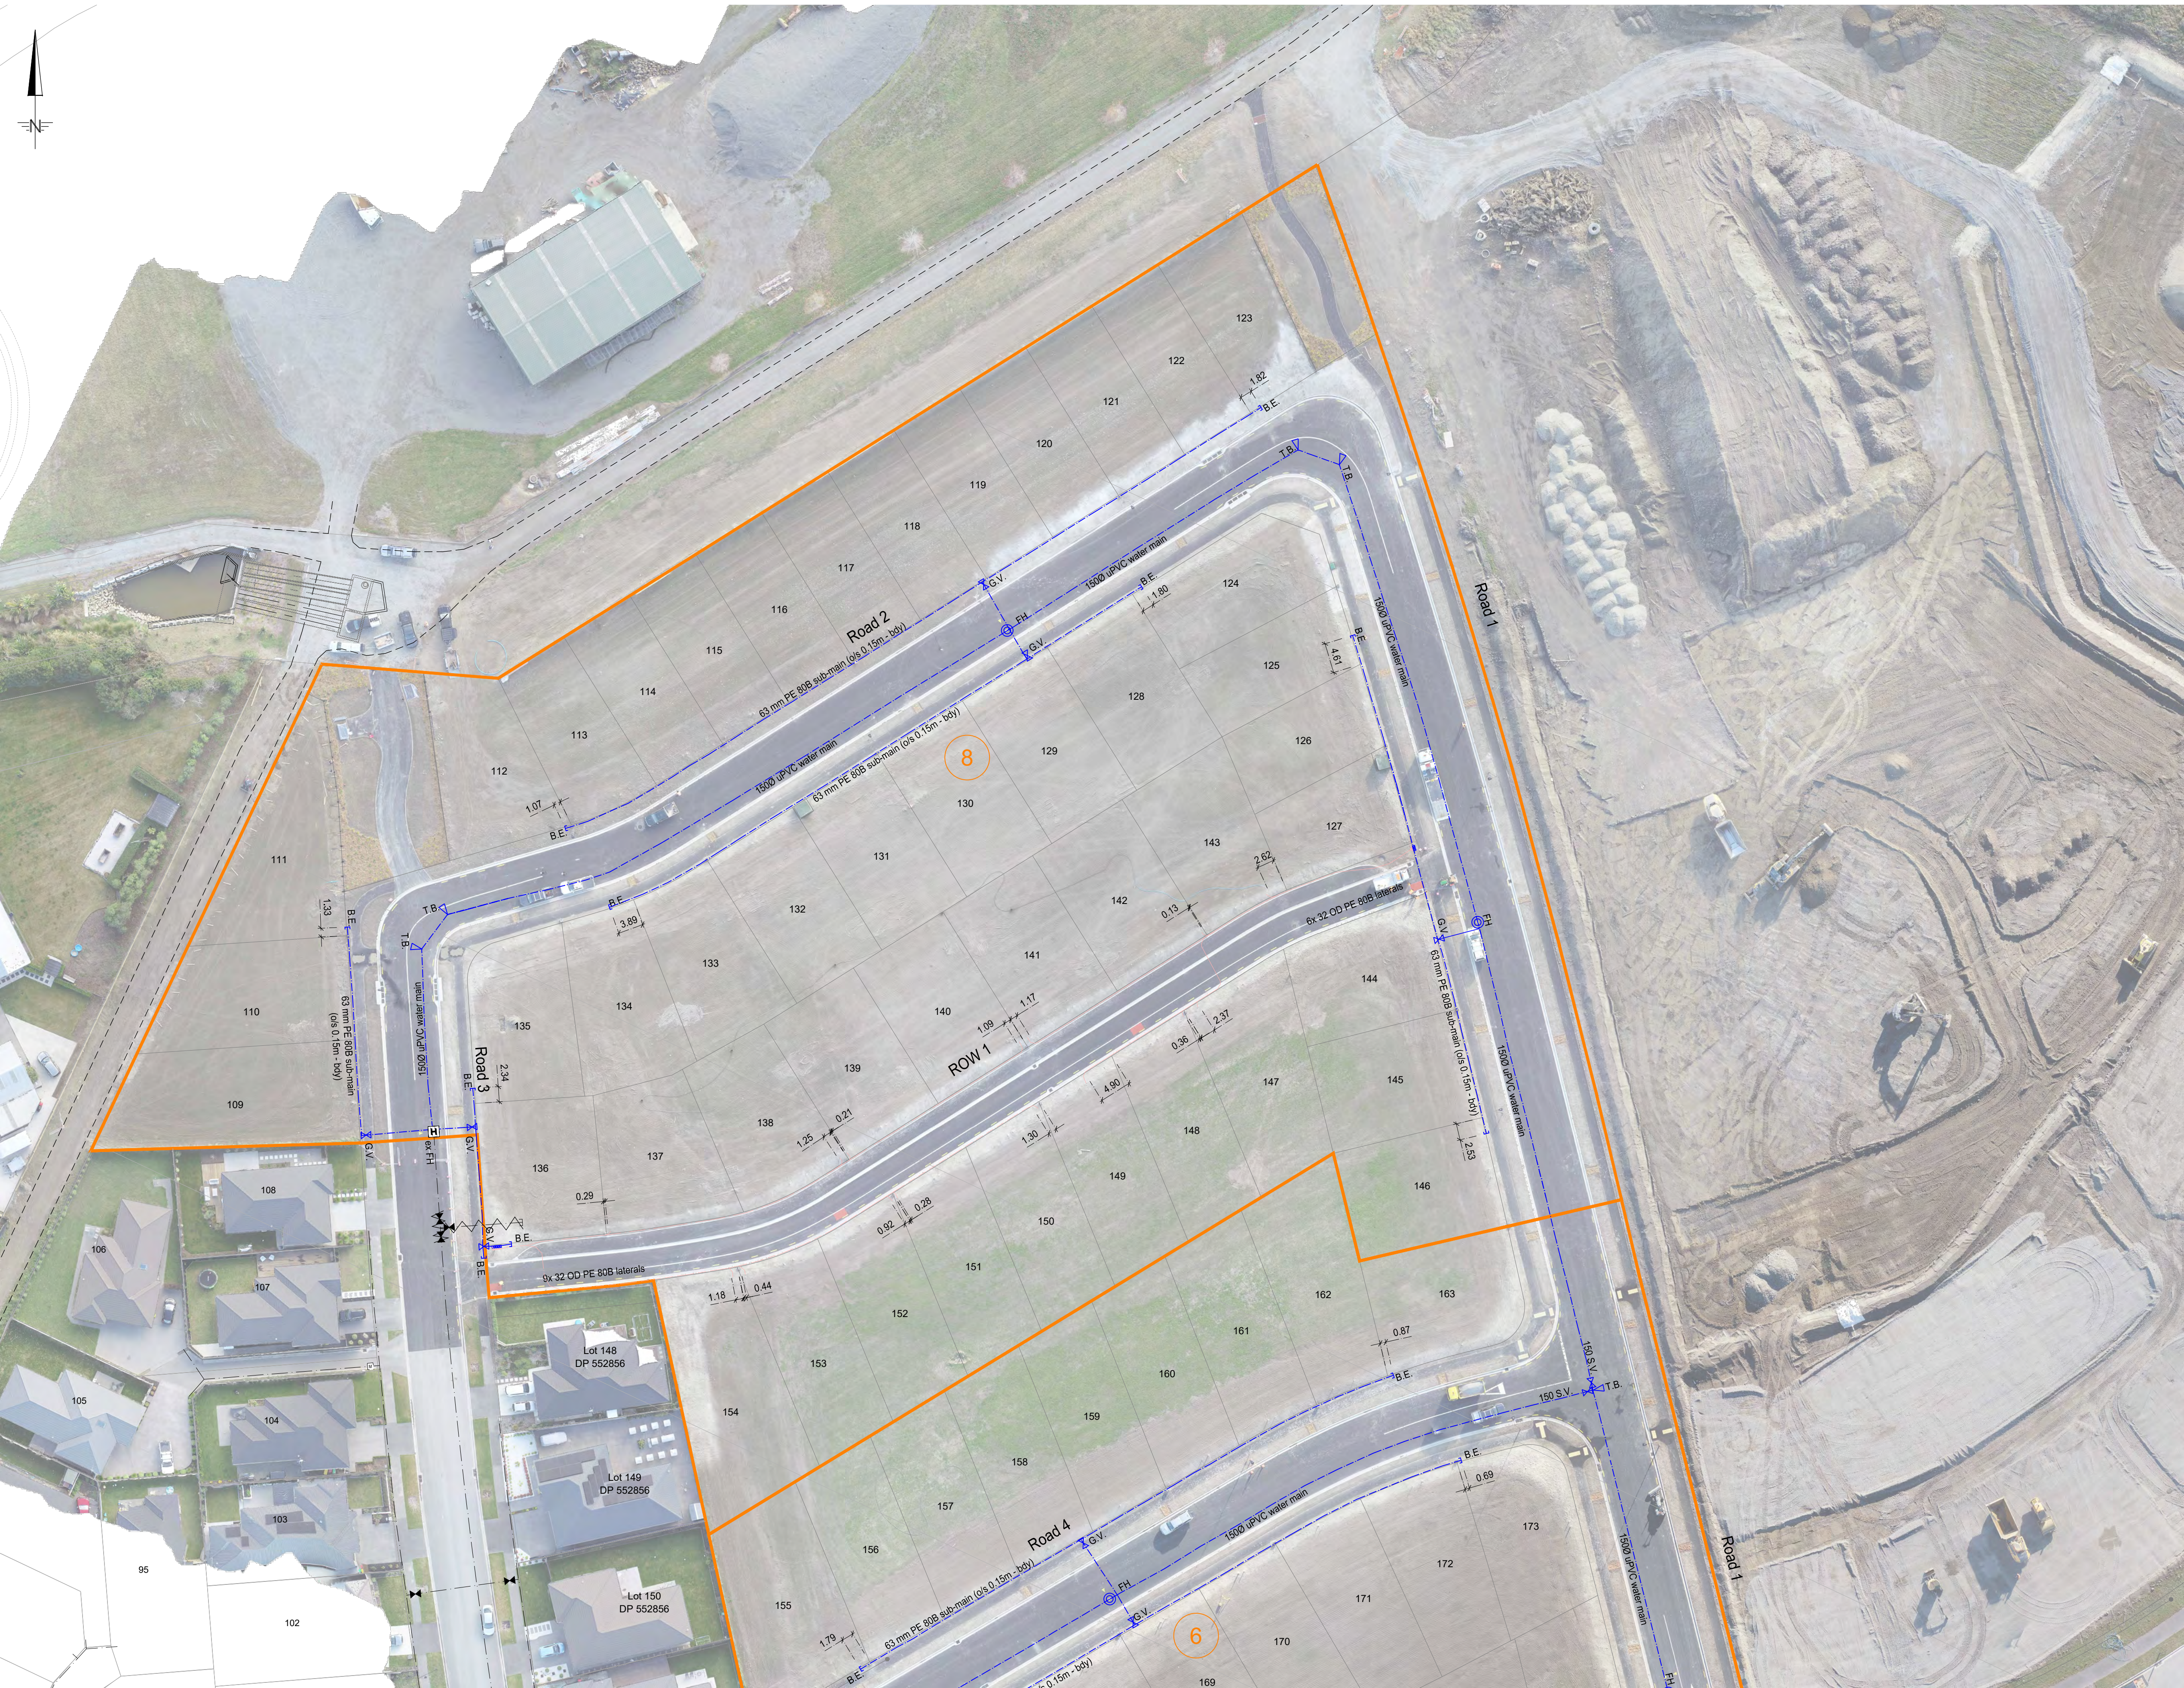

CAD ref: 41556.Asbuilts combined

Rev.	Date	Reason	Approved
AB1	07/26	As-built	DB

AS BUILT